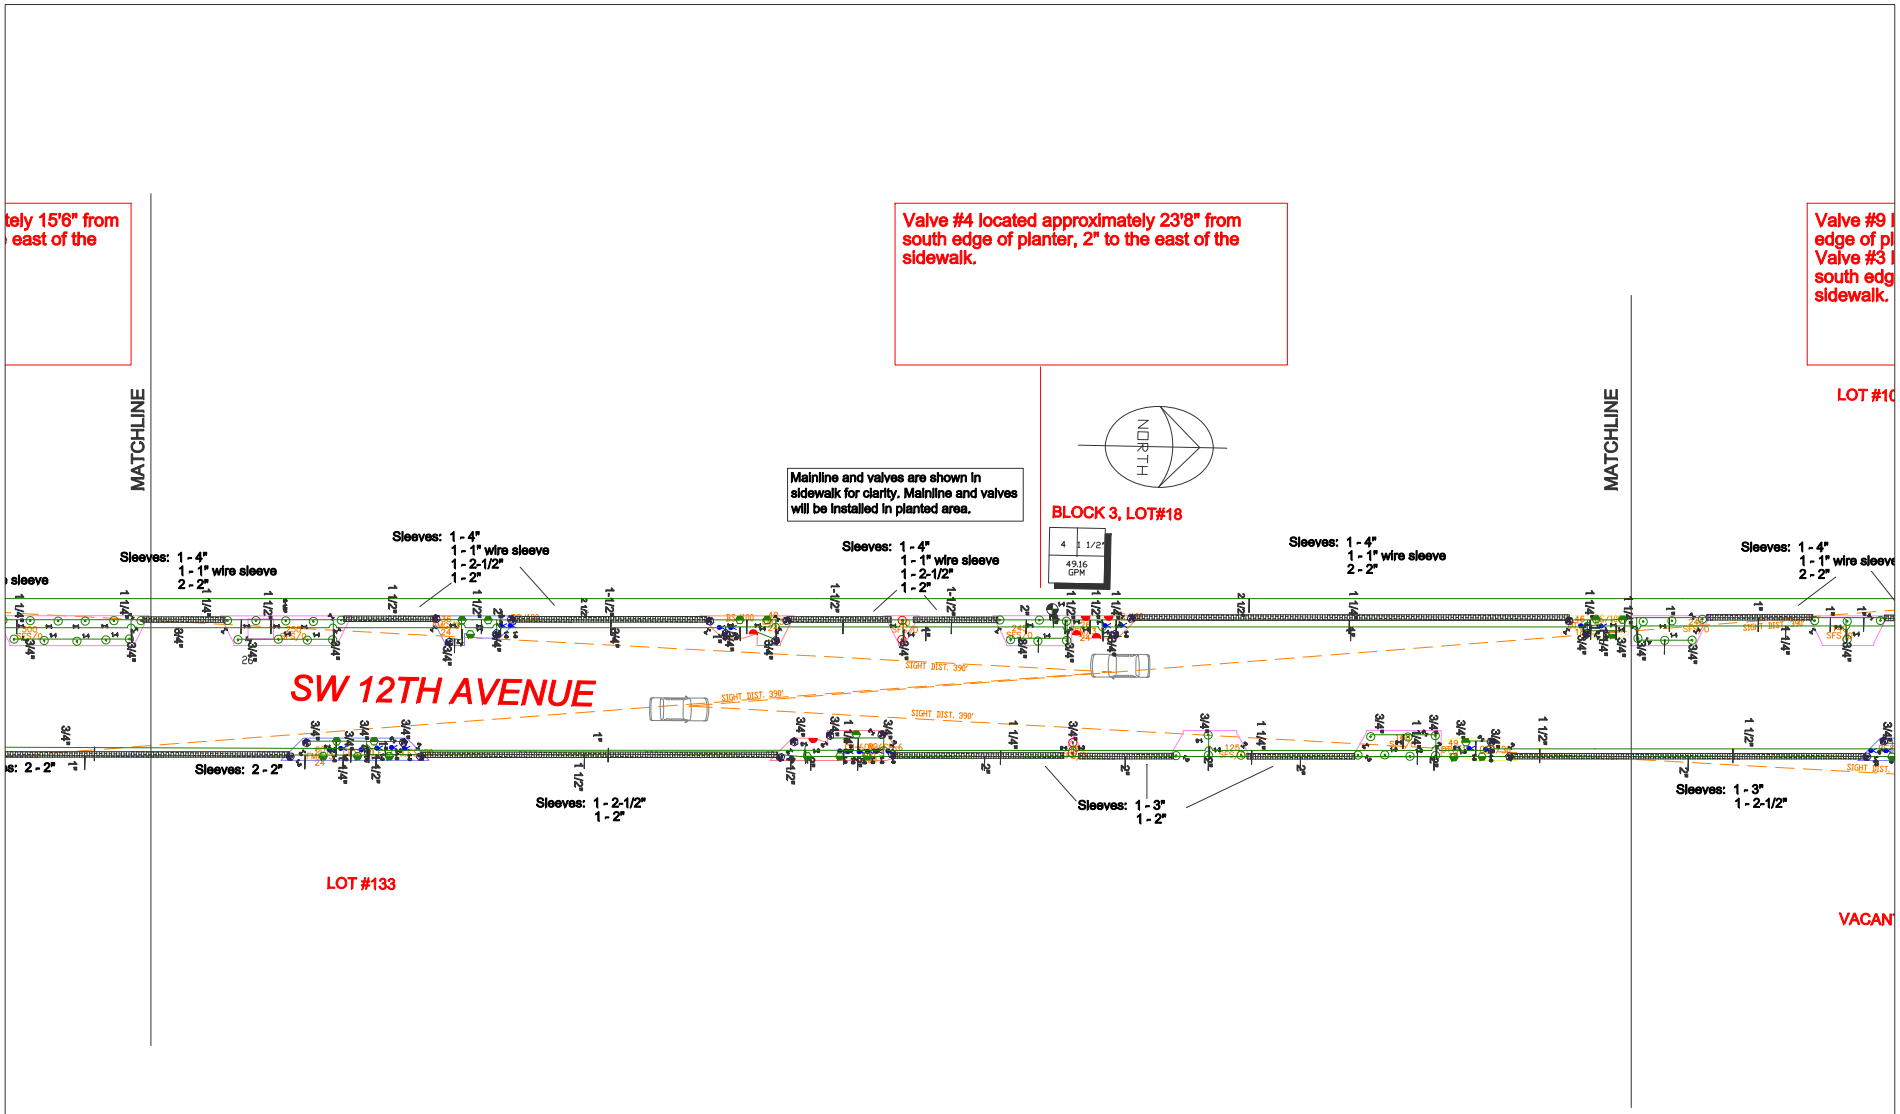

Certified Seal

By	Date	Revisions

Bob Irsay Irrigation Design, Inc.
1003 NW 11th Street
Boynton Beach, FL 33426
(561) 734-3997

Irrigation Plan "As-Built"

City of Delray Beach
SW 12th Avenue/ Auburn Avenue/
SW 14t Avenue
Project 2010-098

Scale: 1" = 20'
Designed:
Approved:
Base Information Supplied By:
Landscape Design Supplied By:
Job Number:

Sheet

Ir-11